


丈量図-1 S=1:500  
(出来形)

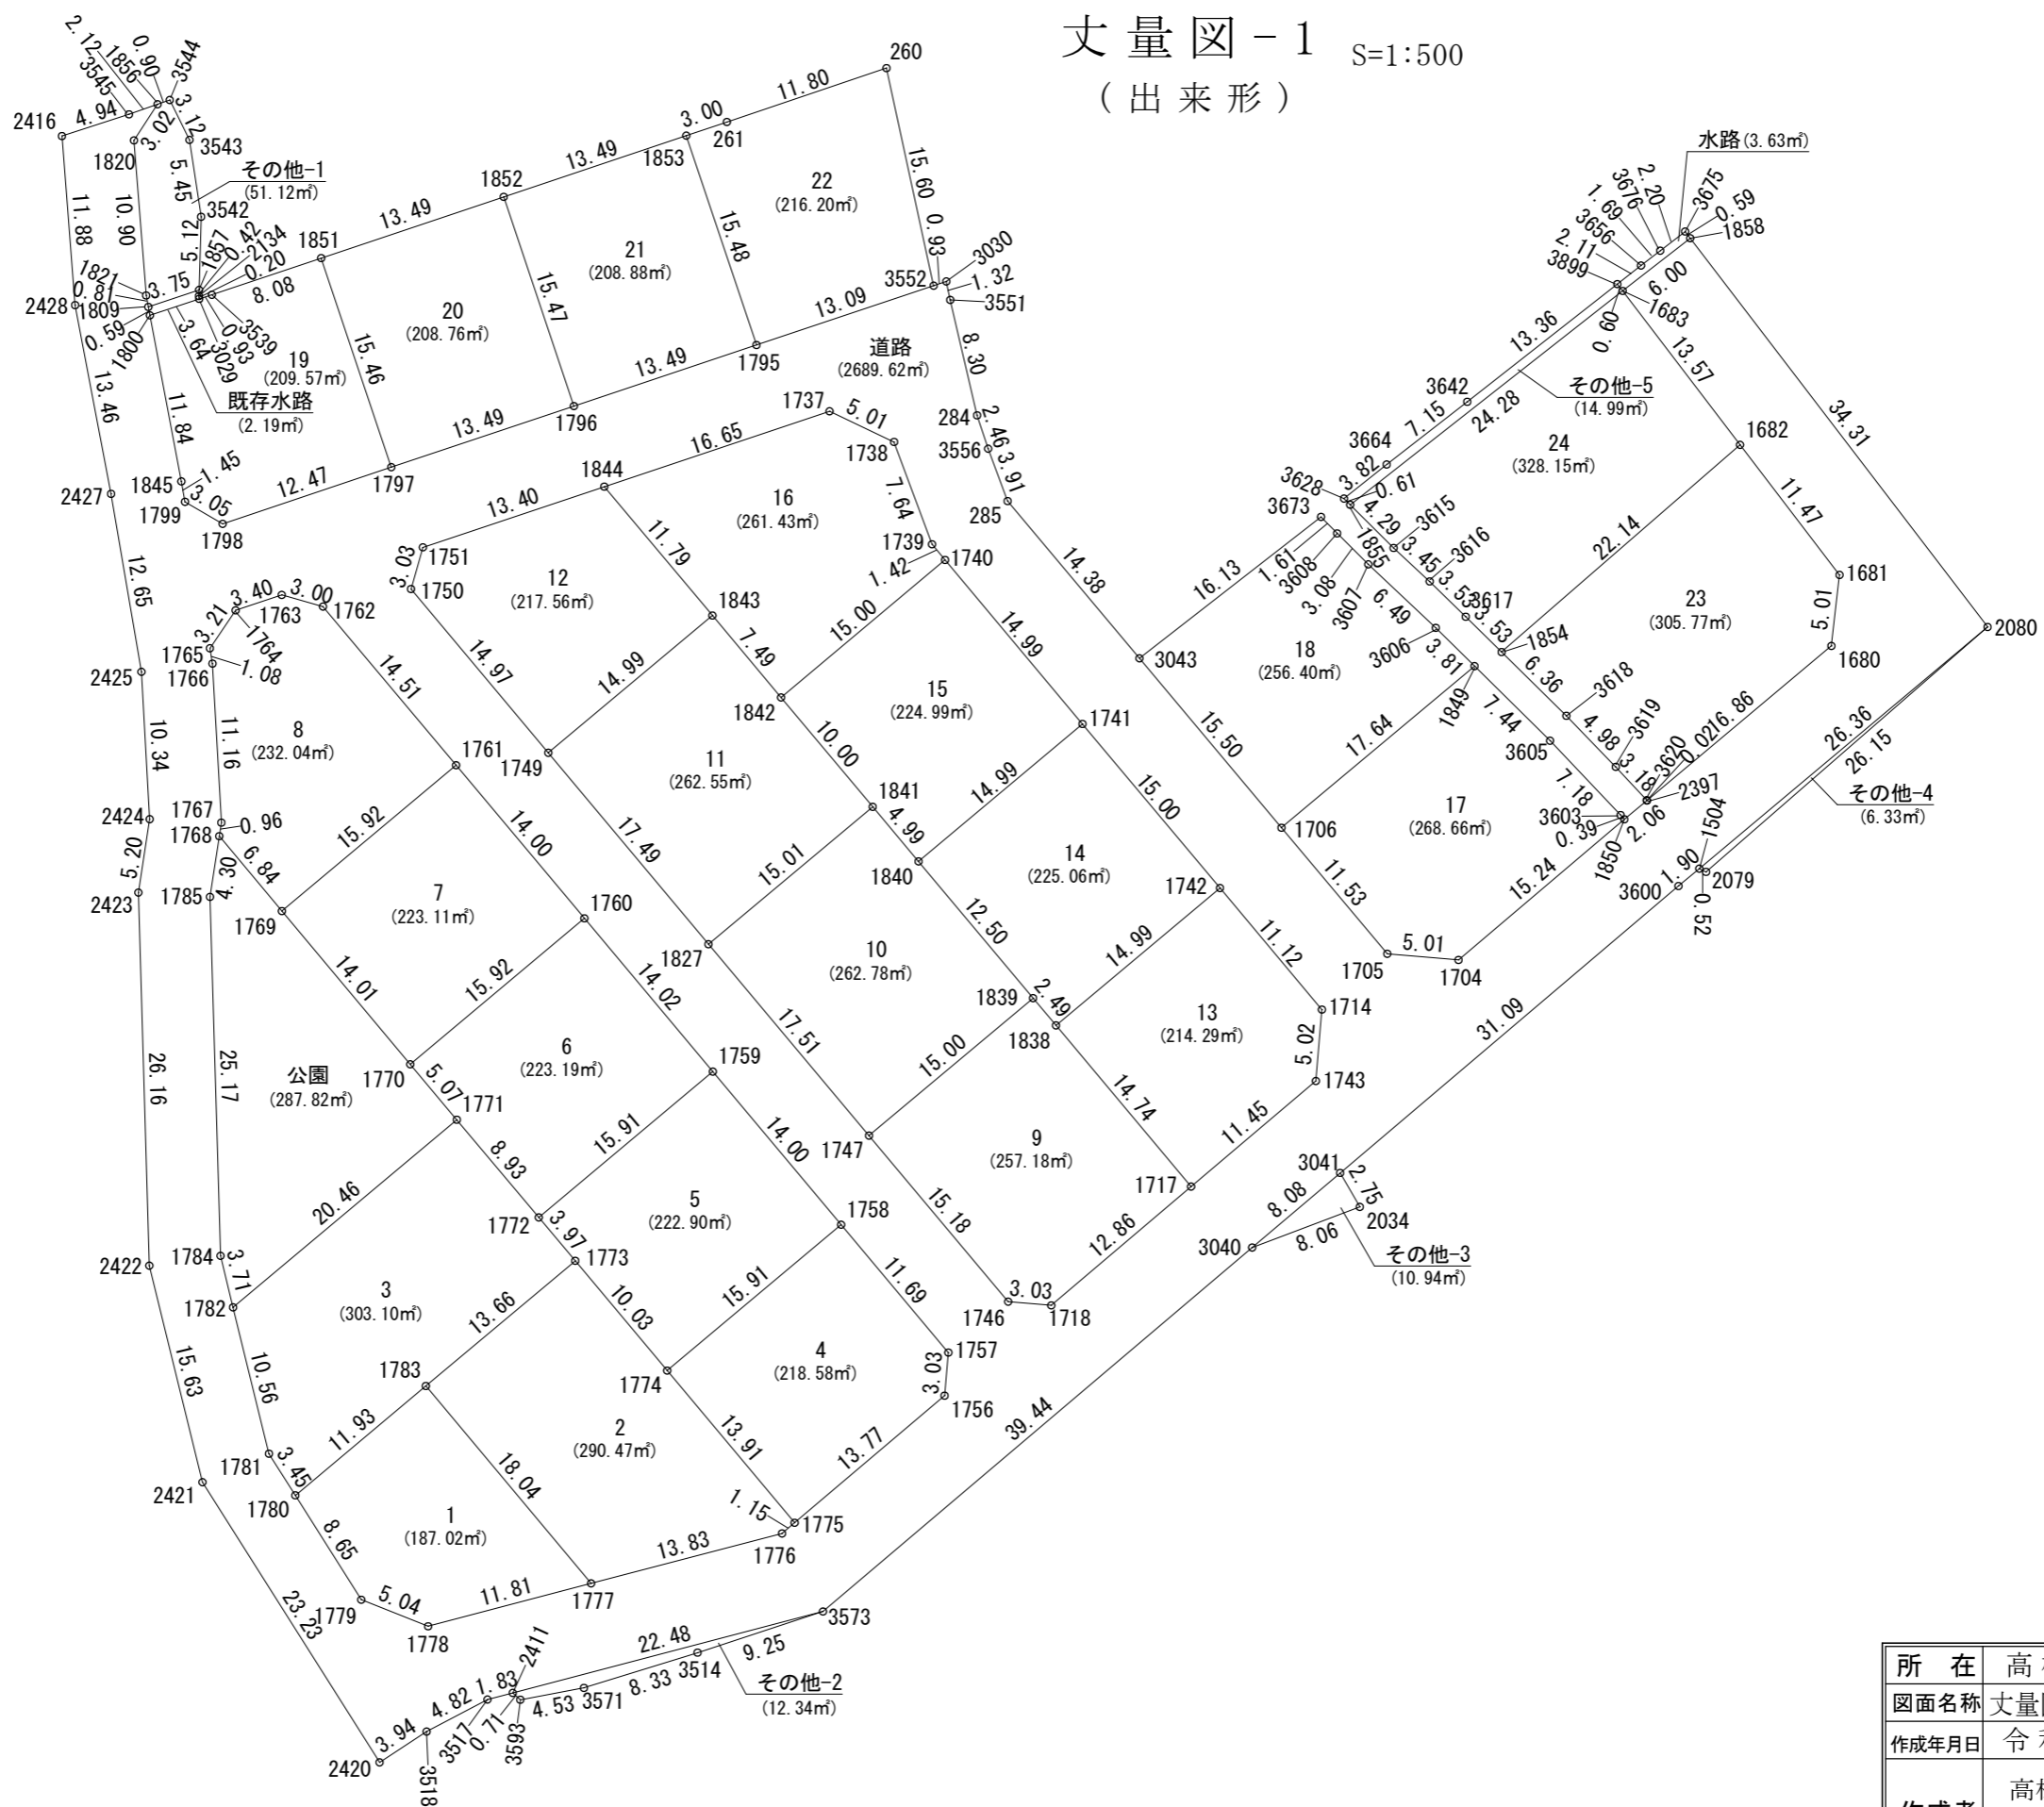

所在	高松市円座町字上円座
図面名称	丈量図-1(出来形) 縮尺 1:500
作成年月日	令和7年11月11日
作成者	高松市三谷町1891番地4 土地家屋調査士 多田幸広

## 丈量図-2 (出来形)

座標求積表

地番	1			
NO	X <sub>n</sub>	Y <sub>n</sub>	X <sub>n</sub> ・(Y <sub>n+1</sub> -Y <sub>n-1</sub> )	距離
1783	142228.733	46499.253	2823382.578783	18.04
1777	142225.579	46517.024	1557796.766787	11.81
1778	142215.931	46510.206	-1650700.311117	5.04
1779	142214.343	46505.417	-1853479.532319	8.65
1780	142216.979	46497.173	-876625.458556	11.93
合計			374.043578	
合計面積			187.0217890	
地積			187.02	m <sup>2</sup>

地番	2			
NO	X <sub>n</sub>	Y <sub>n</sub>	X <sub>n</sub> ・(Y <sub>n+1</sub> -Y <sub>n-1</sub> )	距離
1773	142242.188	46501.634	1744600.435820	10.03
1774	142240.436	46511.518	3355167.404368	13.91
1775	142238.004	46525.222	1921493.196036	1.15
1776	142236.865	46525.027	-1166057.819270	13.83
1777	142225.579	46517.024	-3665722.073146	18.04
1783	142228.733	46499.253	-2188900.200870	13.66
合計			580.942938	
合計面積			290.4714690	
地積			290.47	m <sup>2</sup>

地番	3			
NO	X <sub>n</sub>	Y <sub>n</sub>	X <sub>n</sub> ・(Y <sub>n+1</sub> -Y <sub>n-1</sub> )	距離
1783	142228.733	46499.253	-634482.377913	11.93
1780	142216.979	46497.173	-763847.394209	3.45
1781	142218.028	46493.882	-1680306.000820	10.56
1782	142224.273	46485.358	-705859.066899	20.46
1771	142244.427	46488.919	1758425.606574	8.93
1772	142242.876	46497.720	1808618.168340	3.97
1773	142242.188	46501.634	218057.274204	13.66
合計			606.209277	
合計面積			303.1046385	
地積			303.10	m <sup>2</sup>

地番	4			
NO	X <sub>n</sub>	Y <sub>n</sub>	X <sub>n</sub> ・(Y <sub>n+1</sub> -Y <sub>n-1</sub> )	距離
1758	142256.108	46514.286	2032413.014996	11.69
1757	142254.072	46525.805	1886004.486576	3.03
1756	142251.586	46527.544	-82932.674638	13.77
1775	142238.004	46525.222	-2279506.252104	13.91
1774	142240.436	46511.518	-1555541.408096	15.91
合計			437.166734	
合計面積			218.5833670	
地積			218.58	m <sup>2</sup>

地番	5			
NO	X <sub>n</sub>	Y <sub>n</sub>	X <sub>n</sub> ・(Y <sub>n+1</sub> -Y <sub>n-1</sub> )	距離
1773	142242.188	46501.634	-1962657.710024	3.97
1772	142242.876	46497.720	-161587.907136	15.91
1759	142258.549	46500.498	2356655.122734	14.00
1758	142256.108	46514.286	1567662.310160	15.91
1774	142240.436	46511.518	-1799625.996272	10.03
合計			445.819462	
合計面積			222.9097310	
地積			222.90	m <sup>2</sup>

地番	6			
NO	X <sub>n</sub>	Y <sub>n</sub>	X <sub>n</sub> ・(Y <sub>n+1</sub> -Y <sub>n-1</sub> )	距離
1771	142244.427	46488.919	-1963115.337027	5.07
1770	142245.307	46483.919	-316922.543996	15.92
1760	142260.992	46486.691	2358544.986368	14.02
1759	142258.549	46500.498	1568969.536921	15.91
1772	142242.876	46497.720	-1647030.261204	8.93
合計			446.381062	
合計面積			223.1905310	
地積			223.19	m <sup>2</sup>

地番	7			
NO	X <sub>n</sub>	Y <sub>n</sub>	X <sub>n</sub> ・(Y <sub>n+1</sub> -Y <sub>n-1</sub> )	距離
1769	142247.754	46470.122	-1567428.001326	15.92
1761	142263.435	46472.900	2357162.854515	14.00
1760	142260.992	46486.691	1567573.870848	15.92
1770	142245.307	46483.919	-2356862.491683	14.01
合計			446.232354	
合計面積			223.1161770	
地積			223.11	m <sup>2</sup>

地番	8			
NO	X <sub>n</sub>	Y <sub>n</sub>	X <sub>n</sub> ・(Y <sub>n+1</sub> -Y <sub>n-1</sub> )	距離
1768	142248.954	46463.383	-1029740.178006	0.96
1767	142249.776	46462.883	-1157913.176640	11.16
1766	142257.918	46455.243	-1205066.823378	1.08
1765	142258.623	46454.412	-165020.002680	3.21
1764	142261.820	46454.083	206421.900820	3.40
1763	142264.727	46455.863	643463.360221	3.00
1762	142265.960	46458.606	2423785.160520	14.51
1761	142263.435	46472.900	1638305.717460	15.92
1769	142247.754	46470.122	-1353771.874818	6.84
合計			464.083499	
合計面積			232.0417495	
地積			232.04	m <sup>2</sup>

地番	9			
NO	X <sub>n</sub>	Y <sub>n</sub>	X <sub>n</sub> ・(Y <sub>n+1</sub> -Y <sub>n-1</sub> )	距離
1746	142259.500	46526.721	-2480294.382500	15.18
1747	142262.149	46511.768	-1755657.180809	15.00
1839	142276.921	46514.380	721486.266391	2.49
1838	142276.491	46516.839	2415712.540689	14.74
1717	142273.923	46531.359	1759074.783972	12.86
1718	142261.244	46529.203	-659807.649672	3.03
合計			514.378071	
合計面積			257.1890355	
地積			257.18	m <sup>2</sup>

地番	10			
NO	X <sub>n</sub>	Y <sub>n</sub>	X <sub>n</sub> ・(Y <sub>n+1</sub> -Y <sub>n-1</sub> )	距離
1747	142262.149	46511.768	-2825326.279140	17.51
1827	142265.193	46494.520	-2079917.121660	15.01
1841	142279.975	46497.148	1073929.251300	4.99
1840	142279.108	46502.068	2451753.589056	12.50
1839	142276.921	46514.380	1380086.133700	15.00
合計			525.573256	
合計面積			262.7866280	
地積			262.78	m <sup>2</sup>

所在	高松市円座町字上円座	
図面名称	丈量図-2(出来形)	縮尺
作成年月日	令和7年11月11日	
作成者	高松市三谷町1891番地4 土地家屋調査士 多田幸広	

# 丈量図 - 3

(出来形)

地番	11			
NO	X <sub>n</sub>	Y <sub>n</sub>	X <sub>n</sub> ・(Y <sub>n+1</sub> -Y <sub>n-1</sub> )	距離
1827	142265.193	46494.520	-2824817.672208	17.49
1749	142268.259	46477.292	-2077116.581400	14.99
1843	142283.025	46479.920	1423826.231175	7.49
1842	142281.718	46487.299	2451229.437704	10.00
1841	142279.975	46497.148	1027403.699475	15.01
合計			525.114746	
合計面積			262.5573730	
地積			262.55 m <sup>2</sup>	

地番	12			
NO	X <sub>n</sub>	Y <sub>n</sub>	X <sub>n</sub> ・(Y <sub>n+1</sub> -Y <sub>n-1</sub> )	距離
1749	142268.259	46477.292	-2472480.073161	14.97
1750	142270.868	46462.541	-2275195.721056	3.03
1751	142273.642	46461.300	820065.272488	13.40
1844	142285.075	46468.305	2649348.096500	11.79
1843	142283.025	46479.920	1278697.545675	14.99
合計			435.120446	
合計面積			217.5602230	
地積			217.56 m <sup>2</sup>	

地番	13			
NO	X <sub>n</sub>	Y <sub>n</sub>	X <sub>n</sub> ・(Y <sub>n+1</sub> -Y <sub>n-1</sub> )	距離
1742	142291.260	46519.455	1930607.815680	11.12
1714	142289.322	46530.407	1969853.373768	5.02
1743	142285.216	46533.299	135455.525632	11.45
1717	142273.923	46531.359	-2341828.772580	14.74
1838	142276.491	46516.839	-1693659.348864	14.99
合計			428.593636	
合計面積			214.2968180	
地積			214.29 m <sup>2</sup>	

地番	14			
NO	X <sub>n</sub>	Y <sub>n</sub>	X <sub>n</sub> ・(Y <sub>n+1</sub> -Y <sub>n-1</sub> )	距離
1838	142276.491	46516.839	-722053.191825	2.49
1839	142276.921	46514.380	-2101572.400091	12.50
1840	142279.108	46502.068	-1380249.626708	14.99
1741	142293.876	46504.679	2474063.622012	15.00
1742	142291.260	46519.455	1730261.721600	14.99
合計			450.124988	
合計面積			225.0624940	
地積			225.06 m <sup>2</sup>	

地番	15			
NO	X <sub>n</sub>	Y <sub>n</sub>	X <sub>n</sub> ・(Y <sub>n+1</sub> -Y <sub>n-1</sub> )	距離
1840	142279.108	46502.068	-1071503.962348	4.99
1841	142279.975	46497.148	-2101332.950775	10.00
1842	142281.718	46487.299	-1029977.356602	15.00
1740	142296.492	46489.909	2473113.030960	14.99
1741	142293.876	46504.679	1730151.238284	14.99
合計			449.999519	
合計面積			224.9997595	
地積			224.99 m <sup>2</sup>	

地番	16			
NO	X <sub>n</sub>	Y <sub>n</sub>	X <sub>n</sub> ・(Y <sub>n+1</sub> -Y <sub>n-1</sub> )	距離
1842	142281.718	46487.299	-1421252.081102	7.49
1843	142283.025	46479.920	-2702523.776850	11.79
1844	142285.075	46468.305	-414903.278700	16.65
1737	142299.274	46477.004	1928012.863426	5.01
1738	142300.532	46481.854	1636171.516936	7.64
1739	142296.747	46488.502	1146200.297085	1.42
1740	142296.492	46489.909	-171182.679876	15.00
合計			522.860919	
合計面積			261.4304595	
地積			261.43 m <sup>2</sup>	

地番	17			
NO	X <sub>n</sub>	Y <sub>n</sub>	X <sub>n</sub> ・(Y <sub>n+1</sub> -Y <sub>n-1</sub> )	距離
1849	142314.646	46523.125	1494303.783000	7.44
3605	142314.043	46530.541	2071380.895865	7.18
3603	142313.227	46537.680	1071618.599310	0.39
1850	142313.168	46538.071	-309673.453568	15.24
1704	142298.144	46535.504	-948986.322336	5.01
1705	142295.265	46531.402	-2200311.682695	11.53
1706	142297.269	46520.041	-1177794.495513	17.64
合計			537.324063	
合計面積			268.6620315	
地積			268.66 m <sup>2</sup>	

地番	18			
NO	X <sub>n</sub>	Y <sub>n</sub>	X <sub>n</sub> ・(Y <sub>n+1</sub> -Y <sub>n-1</sub> )	距離
1706	142297.269	46520.041	-2610870.291612	15.50
3043	142299.968	46504.777	-1691092.819712	16.13
3673	142315.744	46508.157	709443.983840	1.61
3608	142315.584	46509.762	665467.670784	3.08
3607	142315.326	46512.833	1359965.255256	6.49
3606	142314.956	46519.318	1464705.527152	3.81
1849	142314.646	46523.125	102893.489058	17.64
合計			512.814766	
合計面積			256.4073830	
地積			256.40 m <sup>2</sup>	

地番	19			
NO	X <sub>n</sub>	Y <sub>n</sub>	X <sub>n</sub> ・(Y <sub>n+1</sub> -Y <sub>n-1</sub> )	距離
1845	142266.301	46445.360	-1463493.438387	11.84
1800	142273.804	46436.188	-1034188.281276	3.64
3029	142276.909	46438.091	341322.304691	0.93
3539	142277.700	46438.587	670412.522400	8.08
1851	142284.593	46442.803	2476321.056572	15.46
1797	142276.523	46455.991	950976.279732	12.47
1798	142265.881	46449.487	-1353802.123596	3.05
1799	142265.369	46446.475	-587129.177863	1.45
合計			419.142273	
合計面積			209.5711365	
地積			209.57 m <sup>2</sup>	

所在	高松市円座町字上円座
図面名称	丈量図-3(出来形) 縮尺 1:500
作成年月日	令和7年11月11日
作成者	高松市三谷町1891番地4 土地家屋調査士 多田幸広

丈量図-4  
(出来形)

地番 20				
NO	X <sub>n</sub>	Y <sub>n</sub>	X <sub>n</sub> ・(Y <sub>n+1</sub> -Y <sub>n-1</sub> )	距離
1851	142284.593	46442.803	-874481.108578	13.49
1852	142296.107	46449.845	2880073.205680	15.47
1796	142288.033	46463.043	874502.250818	13.49
1797	142276.523	46455.991	-2879676.825520	15.46
合計			417.522400	
合計面積			208.7612000	
地積			208.76	m <sup>2</sup>

地番 公園				
NO	X <sub>n</sub>	Y <sub>n</sub>	X <sub>n</sub> ・(Y <sub>n+1</sub> -Y <sub>n-1</sub> )	距離
1784	142226.474	46482.361	-2807266.143812	25.17
1785	142245.277	46465.620	-2699530.866906	4.30
1768	142248.954	46463.383	640404.790908	6.84
1769	142247.754	46470.122	2921199.876144	14.01
1770	142245.307	46483.919	2673785.035679	5.07
1771	142244.427	46488.919	204689.730453	20.46
1782	142224.273	46485.358	-932706.782334	3.71
合計			575.640132	
合計面積			287.8200660	
地積			287.82	m <sup>2</sup>

地番 21				
NO	X <sub>n</sub>	Y <sub>n</sub>	X <sub>n</sub> ・(Y <sub>n+1</sub> -Y <sub>n-1</sub> )	距離
1852	142296.107	46449.845	-875974.834692	13.49
1853	142307.622	46456.887	2881444.730256	15.48
1795	142299.540	46470.093	875995.968240	13.49
1796	142288.033	46463.043	-2881048.092184	15.47
合計			417.771620	
合計面積			208.8858100	
地積			208.88	m <sup>2</sup>

地番 22				
NO	X <sub>n</sub>	Y <sub>n</sub>	X <sub>n</sub> ・(Y <sub>n+1</sub> -Y <sub>n-1</sub> )	距離
1853	142307.622	46456.887	-1656176.104836	3.00
261	142310.184	46458.455	1097353.828824	11.80
260	142320.266	46464.598	2630078.515680	15.60
3552	142310.709	46476.935	781997.345955	13.09
1795	142299.540	46470.093	-2852821.177920	15.48
合計			432.407703	
合計面積			216.2038515	
地積			216.20	m <sup>2</sup>

地番 23				
NO	X <sub>n</sub>	Y <sub>n</sub>	X <sub>n</sub> ・(Y <sub>n+1</sub> -Y <sub>n-1</sub> )	距離
1681	142335.993	46538.613	1988291.486217	5.01
1680	142331.811	46541.378	-24338.739681	16.86
2397	142315.199	46538.442	-421964.565035	0.02
3620	142315.204	46538.413	-454412.446372	3.18
3619	142315.602	46535.249	-1155602.688240	4.98
3618	142316.118	46530.293	-1608741.397872	6.36
1854	142316.623	46523.945	-410441.140732	22.14
1682	142338.495	46527.409	2087821.044660	11.47
合計			611.552945	
合計面積			305.7764725	
地積			305.77	m <sup>2</sup>

地番 24				
NO	X <sub>n</sub>	Y <sub>n</sub>	X <sub>n</sub> ・(Y <sub>n+1</sub> -Y <sub>n-1</sub> )	距離
1682	142338.495	46527.409	1391501.127120	22.14
1854	142316.623	46523.945	-994223.928278	3.53
3617	142316.904	46520.423	-1002622.588680	3.53
3616	142317.175	46516.900	-991808.392575	3.45
3615	142317.348	46513.454	-1099686.147996	4.29
1855	142317.711	46509.173	101757.163365	24.28
1683	142341.472	46514.169	2595739.083392	13.57
合計			656.316348	
合計面積			328.1581740	
地積			328.15	m <sup>2</sup>

所在	高松市円座町字上円座	
図面名称	丈量図-4(出来形)	縮尺
作成年月日	令和7年11月11日	
作成者	高松市三谷町1891番地4 土地家屋調査士 多田幸広	

丈量図-5  
(出来形)

地番	道路			
NO	X <sub>n</sub>	Y <sub>n</sub>	X <sub>n</sub> ・(Y <sub>n+1</sub> -Y <sub>n-1</sub> )	距離
1820	142282.480	46427.447	1138544.404960	10.90
1821	142274.700	46435.087	1177465.417200	0.81
1809	142274.183	46435.723	156643.875483	0.59
1800	142273.804	46436.188	1371092.649148	11.84
1845	142266.301	46445.360	1463493.438387	1.45
1799	142265.369	46446.475	587129.177863	3.05
1798	142265.881	46449.487	1353802.123596	12.47
1797	142276.523	46455.991	1928700.545788	13.49
1796	142288.033	46463.043	2006545.841366	13.49
1795	142299.540	46470.093	1976825.209680	13.09
3552	142310.709	46476.935	1043137.496970	0.93
3030	142311.506	46477.423	218163.538698	1.32
3551	142310.691	46478.468	1093942.281717	8.30
284	142305.703	46485.110	1243609.538517	2.46
3556	142304.408	46487.207	783243.461632	3.91
285	142302.473	46490.614	2500254.450610	14.38
3043	142299.968	46504.777	4187461.158336	15.50
1706	142297.269	46520.041	3788664.787125	11.53
1705	142295.265	46531.402	2200311.682695	5.01
1704	142298.144	46535.504	948986.322336	15.24
1850	142313.168	46538.071	418116.087584	2.06
2397	142315.199	46538.442	470636.363093	16.86
1680	142331.811	46541.378	24338.739681	5.01
1681	142335.993	46538.613	-1988291.486217	11.47
1682	142338.495	46527.409	-3479322.171780	13.57
1683	142341.472	46514.169	-1706389.566336	6.00
1858	142347.346	46515.421	4945289.147386	34.31
2080	142339.865	46548.910	4113479.758635	26.36
1504	142313.898	46544.320	-701038.261548	1.90
3600	142312.024	46543.984	-793247.221776	31.09
3041	142281.372	46538.746	-1520276.459820	6.66
1743	142285.216	46533.299	-1186516.416224	5.02
1714	142289.322	46530.407	-1969853.373768	11.12
1742	142291.260	46519.455	-3660869.537280	15.00
1741	142293.876	46504.679	-4204214.860296	14.99
1740	142296.492	46489.909	-2301930.351084	1.42
1739	142296.747	46488.502	-1146200.297085	7.64
1738	142300.532	46481.854	-1636171.516936	5.01
1737	142299.274	46477.004	-1928012.863426	16.65
1844	142285.075	46468.305	-2234444.817800	13.40
1751	142273.642	46461.300	-820065.272488	3.03
1750	142270.868	46462.541	2275195.721056	14.97
1749	142268.259	46477.292	4549596.654561	17.49
1827	142265.193	46494.520	4904734.793868	17.51
1747	142262.149	46511.768	4580983.459949	15.18
1746	142259.500	46526.721	2480294.382500	3.03
1718	142261.244	46529.203	659807.649672	12.86
1717	142273.923	46531.359	582753.988608	11.45
1743	142285.216	46533.299	1051060.890592	6.66
3041	142281.372	46538.746	581219.404620	8.08
3040	142273.402	46537.384	-1139040.856412	39.44
3573	142234.516	46530.740	-1729856.183592	6.52
1775	142238.004	46525.222	-454592.660784	13.77
1756	142251.586	46527.544	82932.674638	3.03
1757	142254.072	46525.805	-1886004.486576	11.69
1758	142256.108	46514.286	-3600075.325156	14.00
1759	142258.549	46500.498	-3925624.659655	14.02
1760	142260.992	46486.691	-3926118.857216	14.00
1761	142263.435	46472.900	-3995468.571975	14.51
1762	142265.960	46458.606	-2423785.160520	3.00
1763	142264.727	46455.863	-643463.360221	3.40
1764	142261.820	46454.083	-206421.900820	3.21
1765	142258.623	46454.412	165020.002680	1.08
1766	142257.918	46455.243	1205066.823378	11.16

1767	142249.776	46462.883	1157913.176640	0.96
1768	142248.954	46463.383	389335.387098	4.30
1785	142245.277	46465.620	2699530.866906	25.17
1784	142226.474	46482.361	2807266.143812	3.71
1782	142224.273	46485.358	1638565.849233	10.56
1781	142218.028	46493.882	1680306.000820	3.45
1780	142216.979	46497.173	1640472.852765	8.65
1779	142214.343	46505.417	1853479.532319	5.04
1778	142215.931	46510.206	1650700.311117	11.81
1777	142225.579	46517.024	2107925.306359	13.83
1776	142236.865	46525.027	1166057.819270	1.15
1775	142238.004	46525.222	812605.716852	6.52
3573	142234.516	46530.740	-1062491.834520	22.48
2411	142216.167	46517.752	-1997852.714016	1.83
3517	142214.669	46516.692	-410004.890727	4.82
3518	142210.205	46514.869	-421084.417005	3.94
2420	142206.432	46513.731	-3309570.291936	23.23
2421	142213.501	46491.596	-4941776.946249	15.63
2422	142222.737	46478.982	-4268815.451055	26.16
2423	142242.281	46461.581	-2859354.332662	5.20
2424	142246.731	46458.880	-1391599.769373	10.34
2425	142254.275	46451.798	-2380340.783575	12.65
2427	142262.466	46442.147	-2857626.154542	13.46
2428	142270.981	46431.711	-2669430.416503	11.88
2416	142279.465	46423.384	-811846.627290	4.94
3545	142283.655	46426.005	526591.807155	2.12
1856	142285.483	46427.085	205175.666486	3.02
合計			5379.255196	
合計面積			2689.6275980	
地積			2689.62	m <sup>2</sup>

地番	その他-1			
NO	X <sub>n</sub>	Y <sub>n</sub>	X <sub>n</sub> ・(Y <sub>n+1</sub> -Y <sub>n-1</sub> )	距離
1821	142274.700	46435.087	-1177465.417200	10.90
1820	142282.480	46427.447	-1138544.404960	3.02
1856	142285.483	46427.085	14086.262817	0.90
3544	142286.262	46427.546	472674.962364	3.12
3543	142285.006	46430.407	988880.791700	5.45
3542	142281.402	46434.496	1035239.480952	5.12
1857	142277.384	46437.683	174574.350168	3.75
1809	142274.183	46435.723	-369343.779068	0.81
合計			102.246773	
合計面積			51.1233865	
地積			51.12	m <sup>2</sup>

地番	その他-2			
NO	X <sub>n</sub>	Y <sub>n</sub>	X <sub>n</sub> ・(Y <sub>n+1</sub> -Y <sub>n-1</sub> )	距離
3573	142234.516	46530.740	1153095.221212	9.25
3514	142226.655	46525.859	-1335650.517105	8.33
3571	142219.640	46521.349	-1051572.018160	4.53
3593	142216.139	46518.465	-511551.451983	0.71
2411	142216.167	46517.752	1745703.449925	22.48
合計			24.683889	
合計面積			12.3419445	
地積			12.34	m <sup>2</sup>

所在	高松市円座町字上円座	
図面名称	丈量図-5(出来形)	縮尺
作成年月日	令和7年11月11日	
作成者	高松市三谷町1891番地4 土地家屋調査士 多田幸広	

丈量図-6  
(出来形)

地番	その他-3			
NO	X <sub>n</sub>	Y <sub>n</sub>	X <sub>n</sub> ・(Y <sub>n+1</sub> -Y <sub>n-1</sub> )	距離
3041	142281.372	46538.746	561869.138028	2.75
2034	142280.434	46541.333	-193785.951108	8.06
3040	142273.402	46537.384	-368061.290974	8.08
		合計	21.895946	
	合計	面積	10.9479730	
		地積	10.94 m <sup>2</sup>	

地番	その他-4			
NO	X <sub>n</sub>	Y <sub>n</sub>	X <sub>n</sub> ・(Y <sub>n+1</sub> -Y <sub>n-1</sub> )	距離
2080	142339.865	46548.910	72735.671015	26.15
2079	142314.029	46544.831	-653221.393110	0.52
1504	142313.898	46544.320	580498.389942	26.36
		合計	12.667847	
	合計	面積	6.3339235	
		地積	6.33 m <sup>2</sup>	

地番	その他-5			
NO	X <sub>n</sub>	Y <sub>n</sub>	X <sub>n</sub> ・(Y <sub>n+1</sub> -Y <sub>n-1</sub> )	距離
3628	142317.764	46508.563	20636.075780	3.82
3664	142321.516	46509.318	321219.661612	7.15
3642	142328.515	46510.820	605750.159840	13.36
3899	142341.596	46513.574	476702.005004	0.60
1683	142341.472	46514.169	-626444.818272	24.28
1855	142317.711	46509.173	-797833.087866	0.61
		合計	29.996098	
	合計	面積	14.9980490	
		地積	14.99 m <sup>2</sup>	

地番	水路			
NO	X <sub>n</sub>	Y <sub>n</sub>	X <sub>n</sub> ・(Y <sub>n+1</sub> -Y <sub>n-1</sub> )	距離
3899	142341.596	46513.574	-22632.313764	2.11
3656	142343.664	46514.010	113590.243872	1.69
3676	142345.325	46514.372	118716.001050	2.20
3675	142347.476	46514.844	149322.502324	0.59
1858	142347.346	46515.421	-96084.458550	6.00
1683	142341.472	46514.169	-262904.698784	0.60
		合計	7.276148	
	合計	面積	3.6380740	
		地積	3.63 m <sup>2</sup>	

地番	既存水路			
NO	X <sub>n</sub>	Y <sub>n</sub>	X <sub>n</sub> ・(Y <sub>n+1</sub> -Y <sub>n-1</sub> )	距離
1857	142277.384	46437.683	316282.624632	0.42
2134	142277.054	46437.946	58049.038032	0.20
3029	142276.909	46438.091	-250122.806022	3.64
1800	142273.804	46436.188	-336904.367872	0.59
1809	142274.183	46435.723	212699.903585	3.75
		合計	4.392355	
	合計	面積	2.1961775	
		地積	2.19 m <sup>2</sup>	

合計 8907.62 m<sup>2</sup>

所在	高松市円座町字上円座	
図面名称	丈量図-6(出来形)	縮尺
作成年月日	令和7年11月11日	
作成者	高松市三谷町1891番地4 土地家屋調査士 多田幸広	